




SOUTH ELEVATION

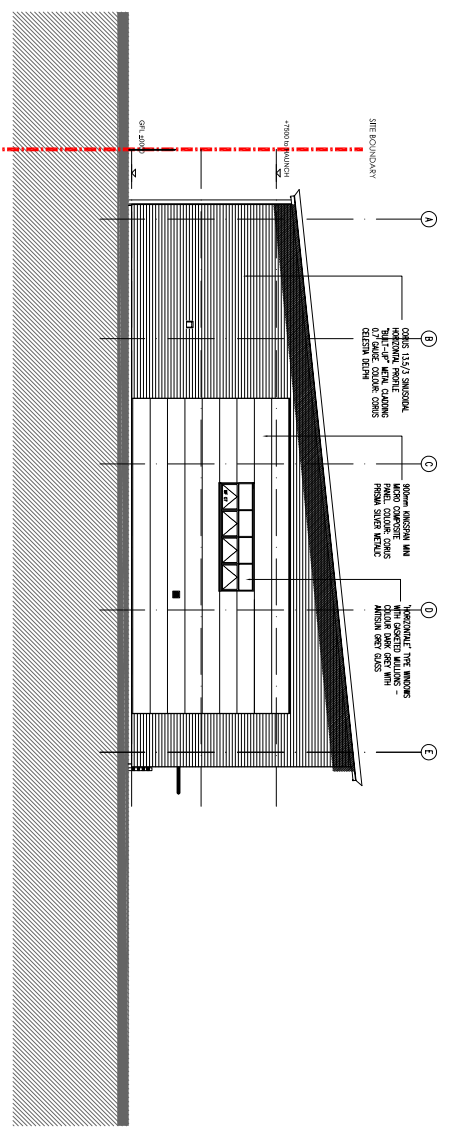

WEST ELEVATION

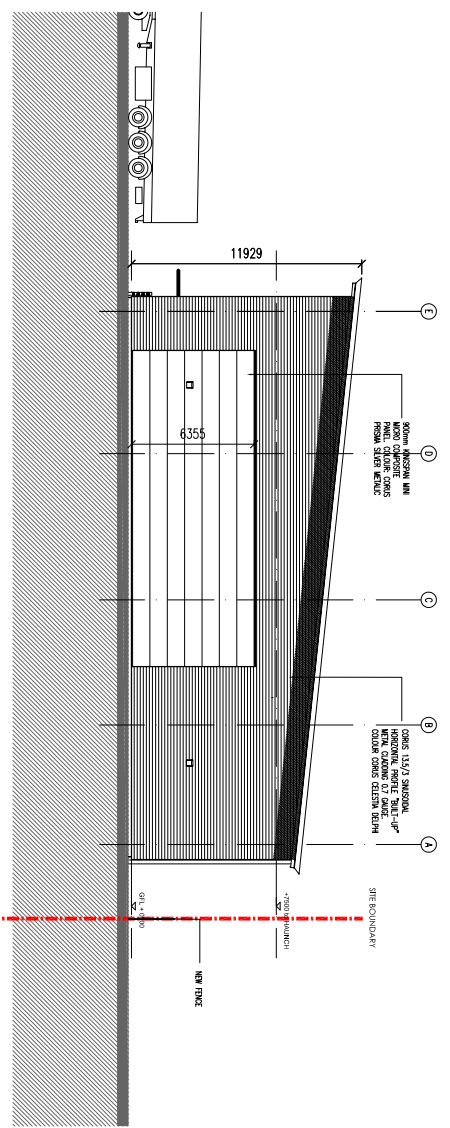

EAST ELEVATION

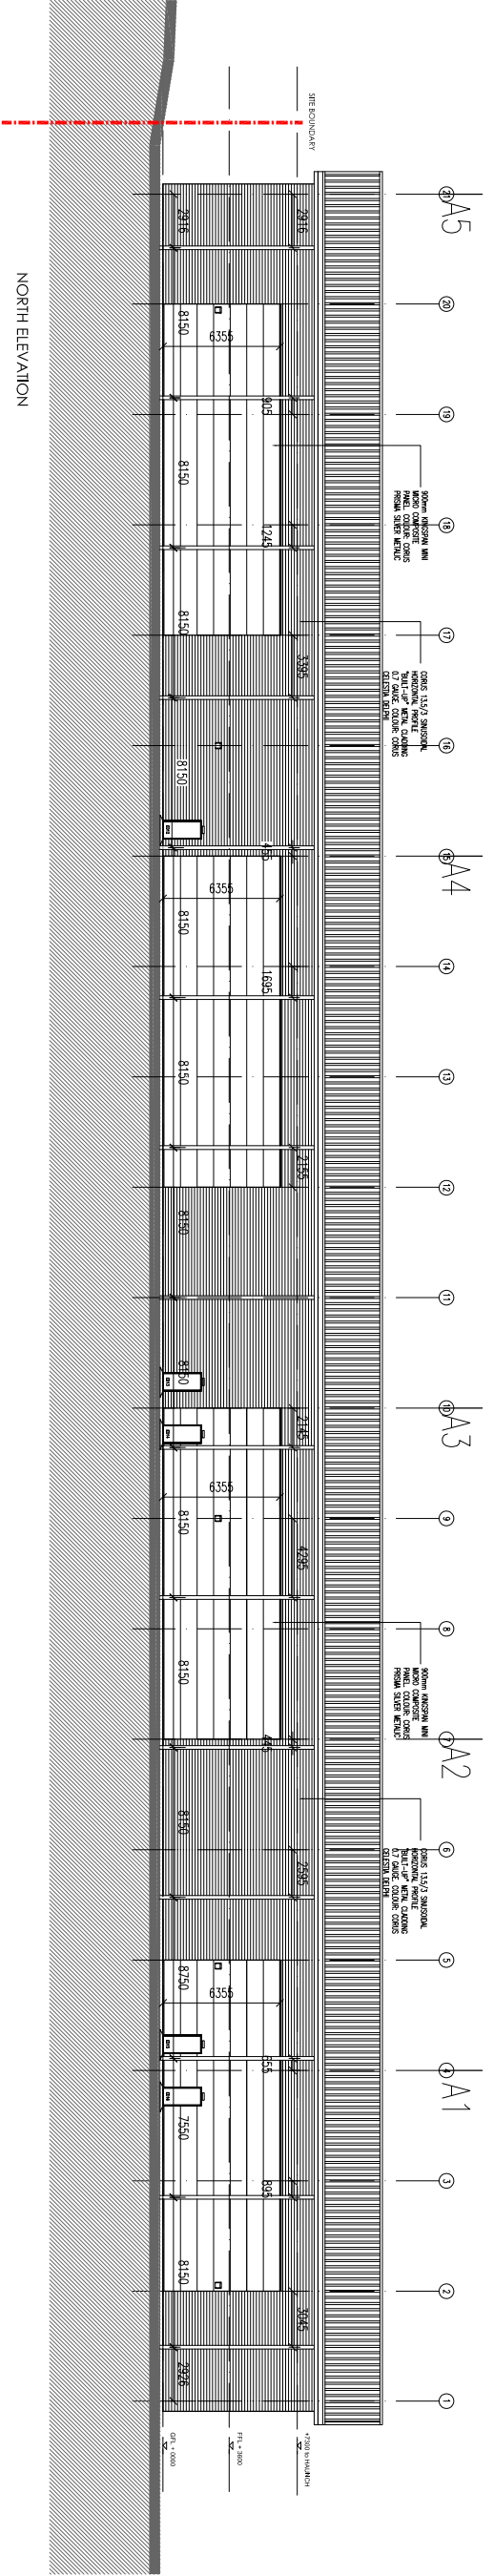

NORTH ELEVATION

SOUTHERN COMMERCIAL  
 UNIT A - PROPOSED ELEVATIONS

DATE: | DRAWN BY: |  
**FletcherArchitects**  
 Designers & Master Planners  
 UNITS 1 & 2 RIVERSIDE MEWS  
 COMMERCIAL STREET  
 MANCHESTER M13 9HQ  
 T +44(0)161 838 5360  
 F +44(0)161 838 5361  
 office@fletcherarchitects-uk.com  
 www.fletcherarchitects-uk.com

UNIT A - PROPOSED ELEVATIONS  
 SOUTHERN COMMERCIAL

AS BUILT ISSUE

SCALE 1:200 @ A1

PROPOSED COMMERCIAL DEVELOPMENT  
 for HELIOS (INDUSTRIAL DEVELOPMENTS) LTD  
 UNIT A - PROPOSED ELEVATIONS  
 STATUS: AB | P+ PRELIMINARY | 3 SHEETS | 22.03.07  
 DRAWN: RCT | CHECKED BY: | 1:2000@A1  
**1221 - AB101** -