




SECTION A-A

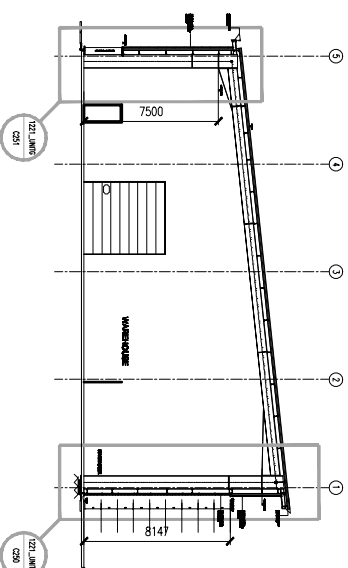

SECTION B-B

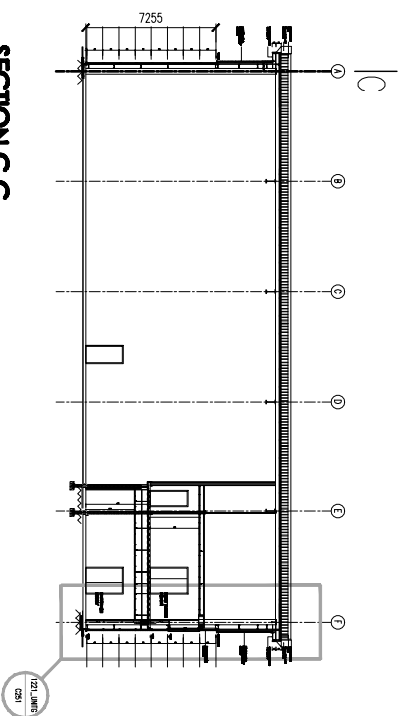

SECTION C-C

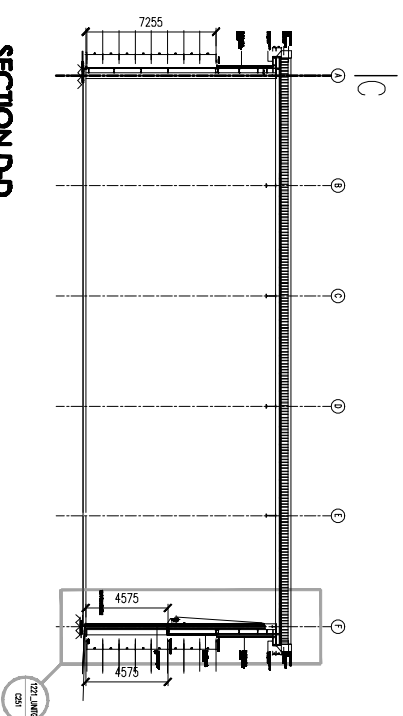

SECTION D-D

SOUTHERN COMMERCIAL
 UNIT GA - GA SECTION 1:200

FletcherArchitects
 Designers & Master Planners

UNITS 1 & 2 PROPOSED NEW
 MANUFACTURING UNIT
 MANCHESTER IND. AIRP
 T +44(0)161 888 8800
 F +44(0)161 888 8801
 www.fletcherarchitects.co.uk

UNIT G - GA SECTIONS
 SOUTHERN COMMERCIAL

AS BUILT ISSUE

SCALE 1:200 @ A1

PROPOSED COMMERCIAL DEVELOPMENT	DATE / DATE	ISSUED BY
for HELIOS (INDUSTRIAL DEVELOPMENTS) LTD		
UNIT G - GA SECTIONS		
STATUS : AS - PROPOSED	1 - 3/2020	09.06.07
DRAWN : RCT	CHECKED BY:	1:20000A1
1221 - AB152		-