




WEST ELEVATION
(ALONG GL B)

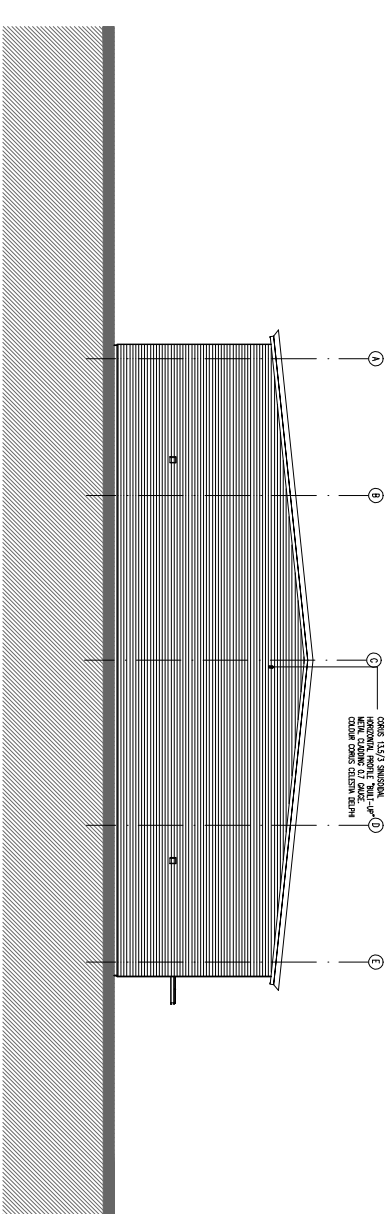

NORTH ELEVATION
(ALONG GL I)

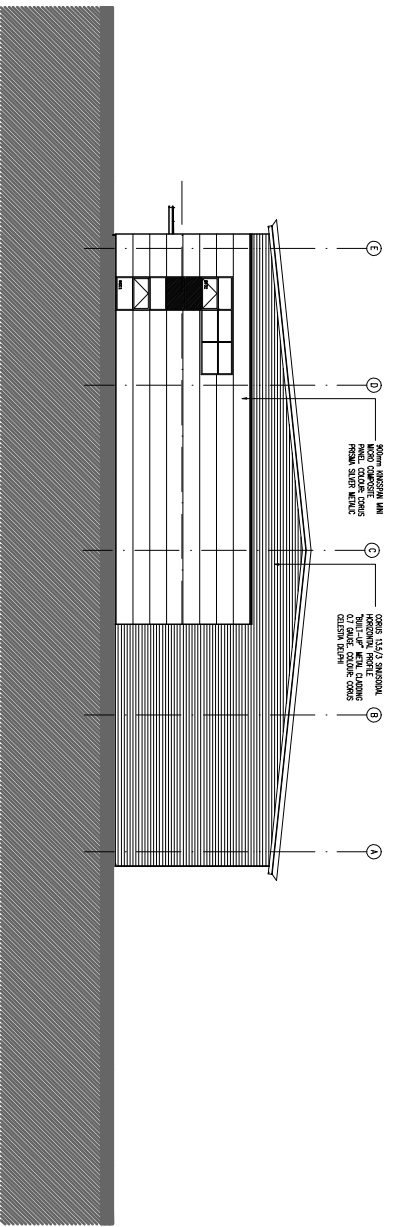

SOUTH ELEVATION
(ALONG GL J)

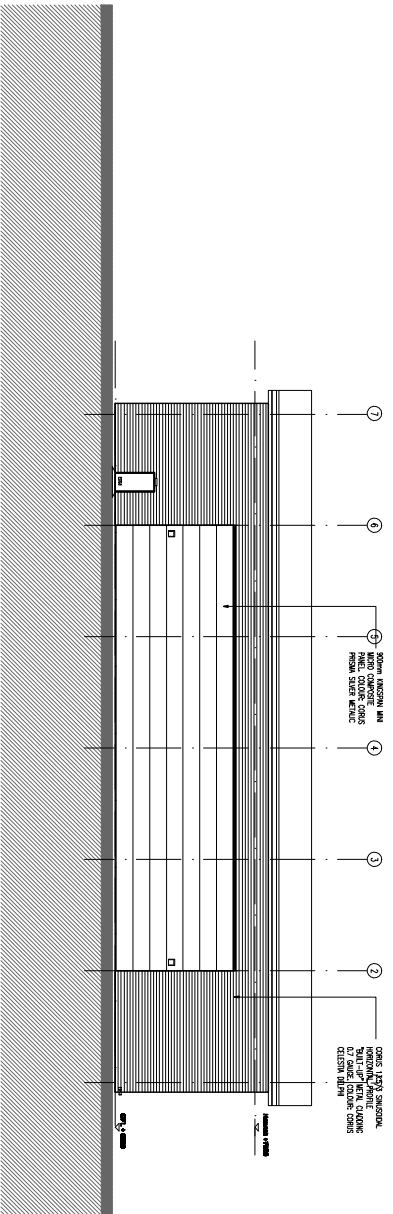

EAST ELEVATION
(ALONG GL A)

SOUTHERN COMMERCIAL
 UNIT J - PROPOSED GA PLAN 1:200

REV. DATE. SCALE BY

FletcherArchitects
 Designers & Master Planners

UNITS 1 & 2 RIVERSIDE LODGE
 COMMERCIAL STREET
 MANCHESTER M15 4RQ
 T +44(0)161 888 1390
 F +44(0)161 888 1391
 info@fletcherarchitects-uk.com
 www.fletcherarchitects-uk.com

PROPOSED COMMERCIAL DEVELOPMENT			
for HELIOS (INDUSTRIAL DEVELOPMENTS) LTD			
UNIT J - ELEVATIONS			
STATUS	AS	REVISION	30.04.07
DRAWN BY:	RCI	CHECKED BY:	1:200GA1
1221 - AB161			

UNIT J - ELEVATION
 SOUTHERN COMMERCIAL

AS BUILT ISSUE

SCALE 1:200 @ A1