Copyright Reserved to Fletcher Architects UK Ltd

These plans and specifications are the property of Fletcher Architects UK Ltd, and shall not be re-printed or reproduced, in whole or part, without their written consent, nor shall any building or structure be constructed in accordance with such plans and specifications or any modifications thereof without the written consent of Fletcher Architects UK Ltd.

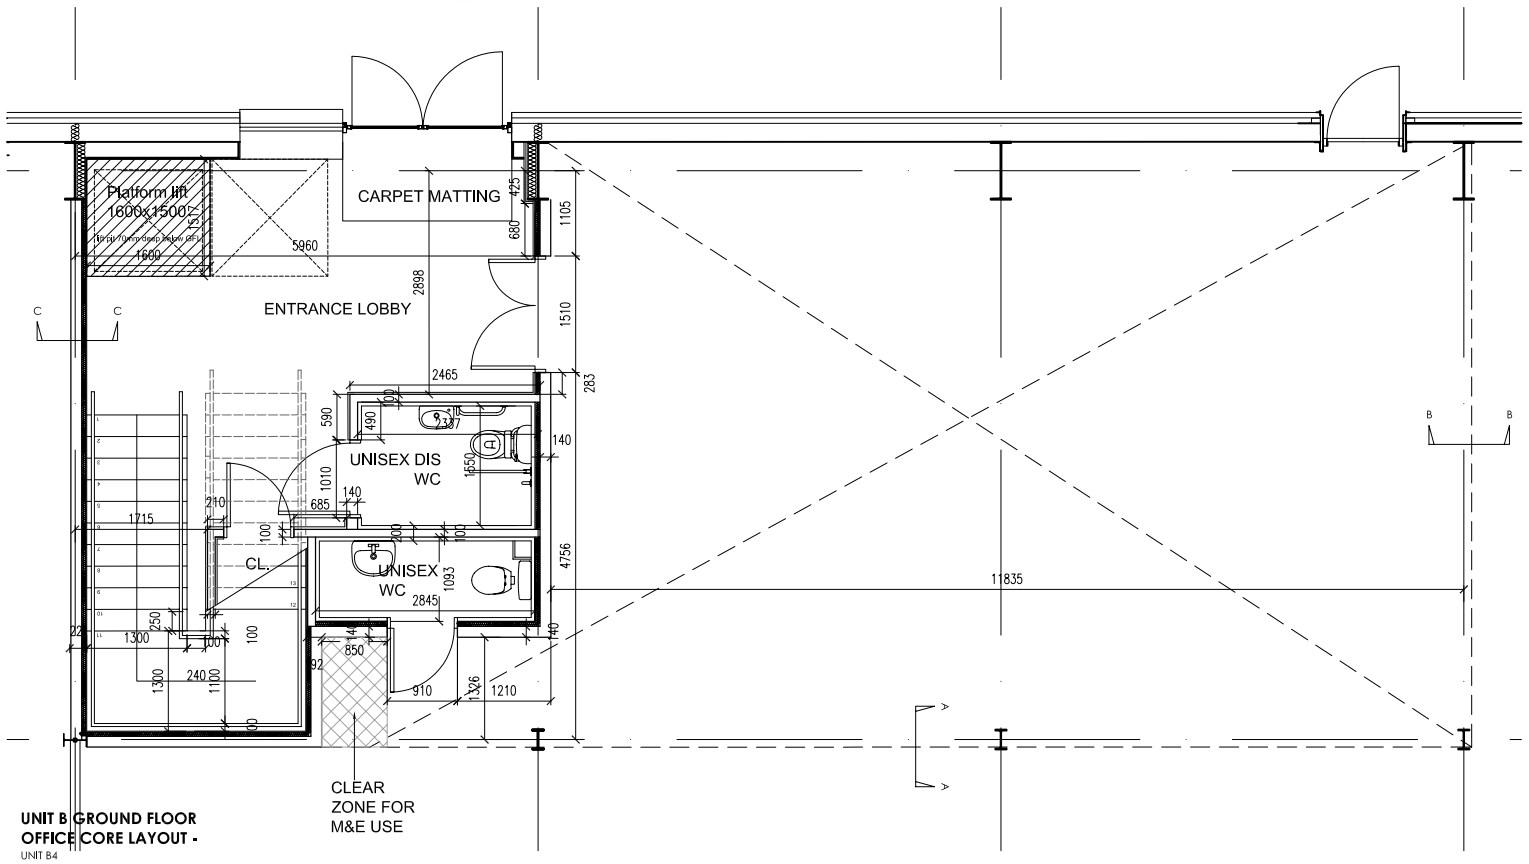

UNIT B GROUND FLOOR OFFICE CORE LAYOUT -
UNIT B4

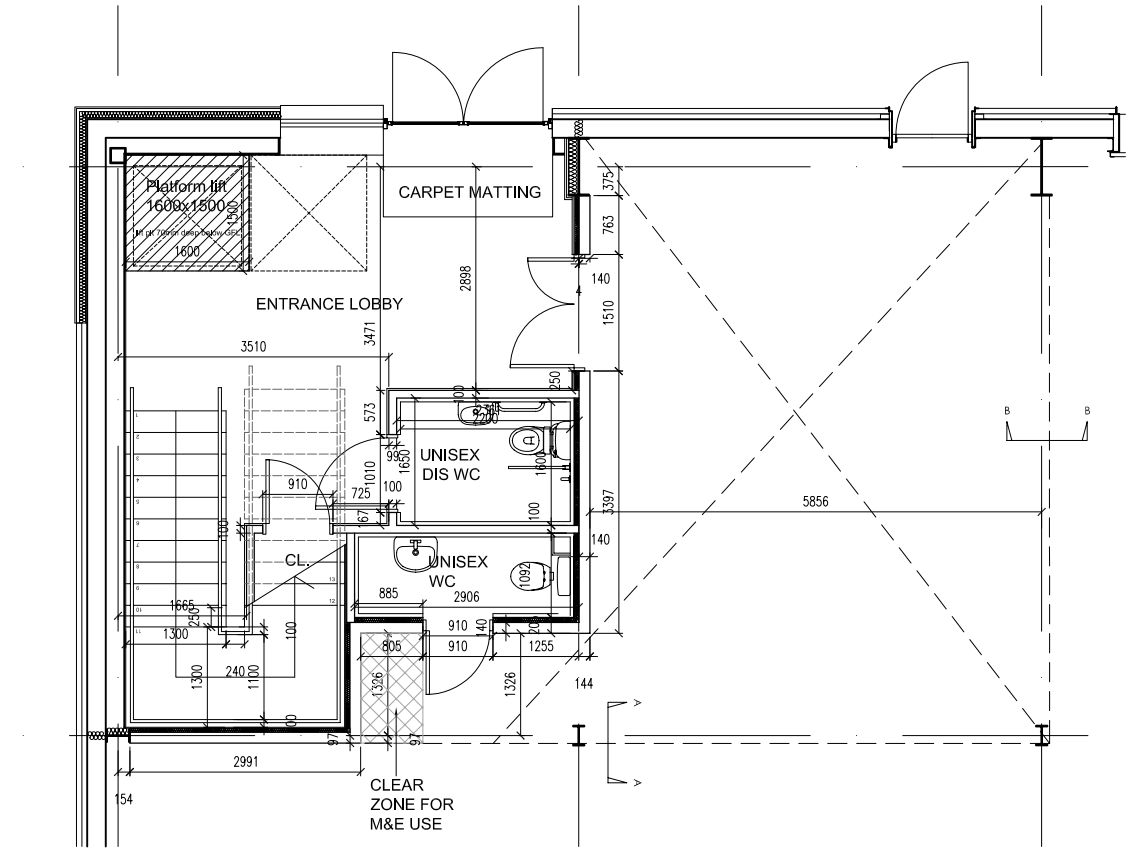

UNIT B GROUND FLOOR OFFICE CORE LAYOUT -
UNIT B1

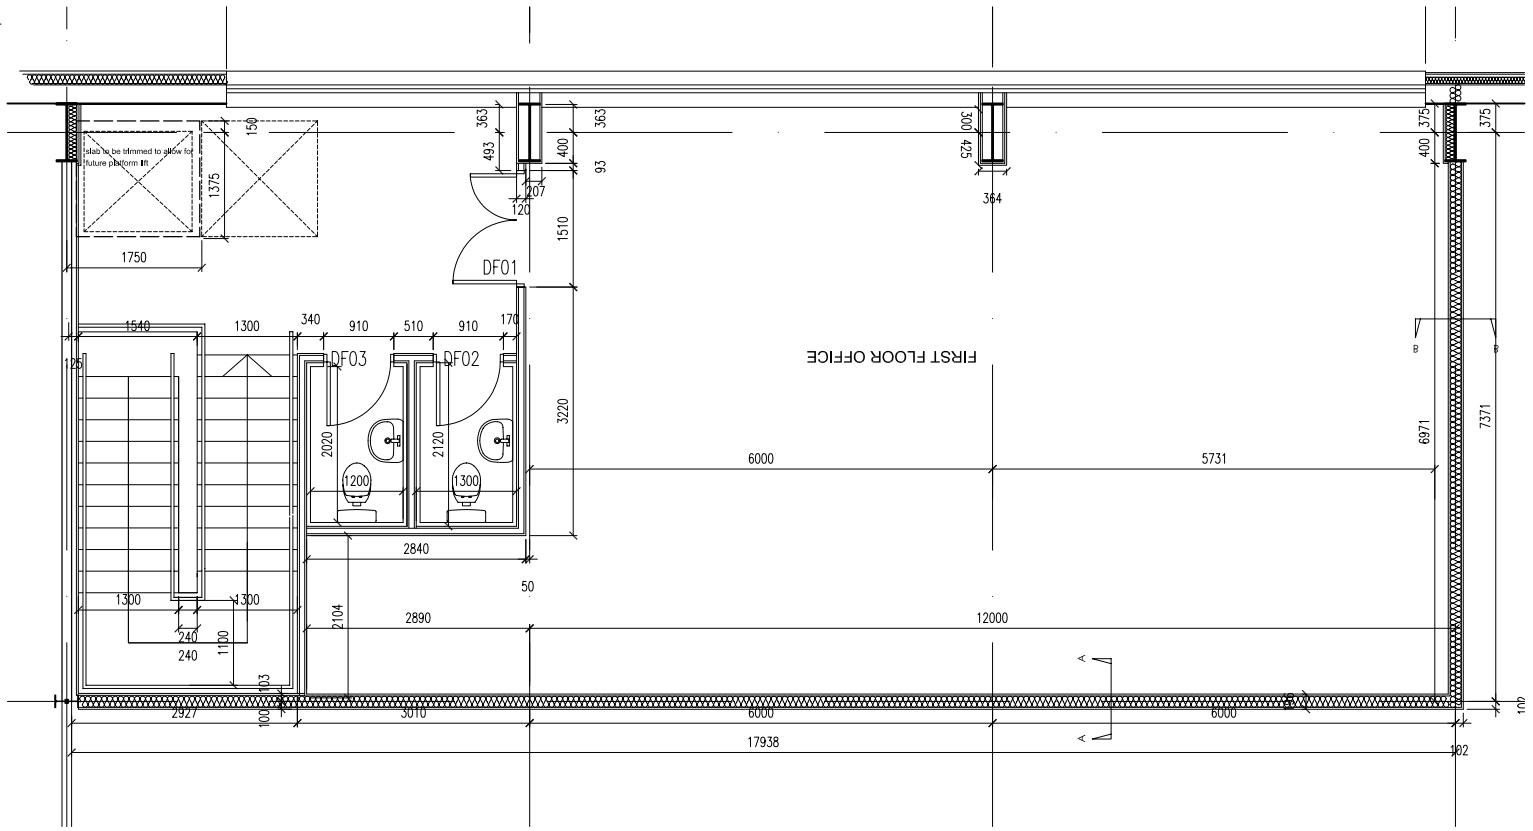

UNIT B FIRST FLOOR OFFICE CORE LAYOUT -
UNIT B4

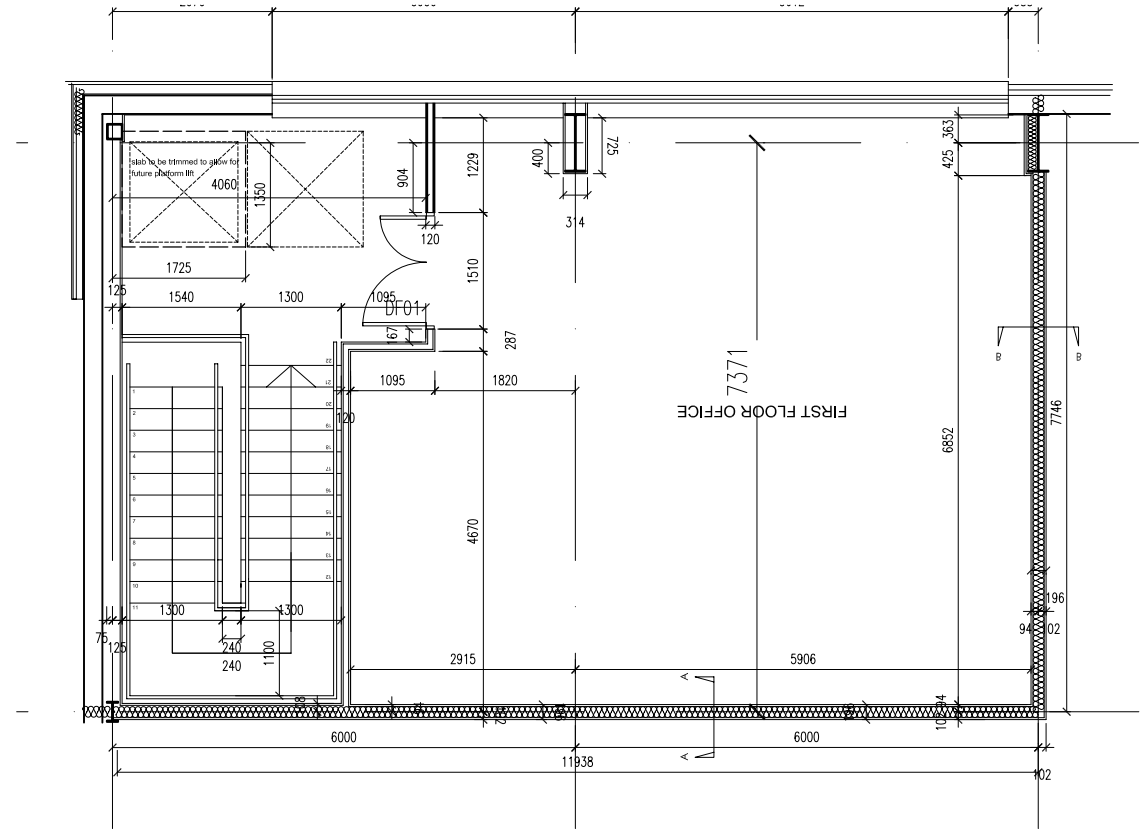

UNIT B FIRST FLOOR OFFICE CORE LAYOUT -
UNIT B1

UNIT B - OFFICE CORE LAYOUTS
SOUTHERN COMMERCIAL

AS BUILT ISSUE

SCALE 1:50 @ A1

SOUTHERN COMMERCIAL

UNIT B - OFFICE CORE LAYOUTS 1:50

REV	DATE	DRAWN BY

FletcherArchitects
Designers & Master Planners

UNITS 1 & 2 RIVERSIDE MEWS
COMMERCIAL STREET
MANCHESTER M15 4RQ

T +44(0)161 838 5360
F +44(0)161 838 5361

office@fletcherarchitects-uk.com
www.fletcherarchitects-uk.com

PROPOSED COMMERCIAL DEVELOPMENT			
for HELIOS (INDUSTRIAL DEVELOPMENTS) LTD			
UNIT B - OFFICE CORE LAYOUTS			
STATUS	AB	P = PRELIMINARY C = CONSTRUCTION T = TENDER S = SKETCH	22.03.07
DRAWN :	RCT	CHECKED BY:	1:50@A1
1221 - AB114			-