heliscity

Copyright Reserved to Fletcher Architects UK Ltd

These plans and specifications are the property of Fletcher Architects UK Ltd, and shall not be re-printed or reproduced, in whole or part, without their written consent, nor shall any building or structure be constructed in accordance with such plans and specifications or any modifications thereof without the written consent of Fletcher Architects UK Ltd.

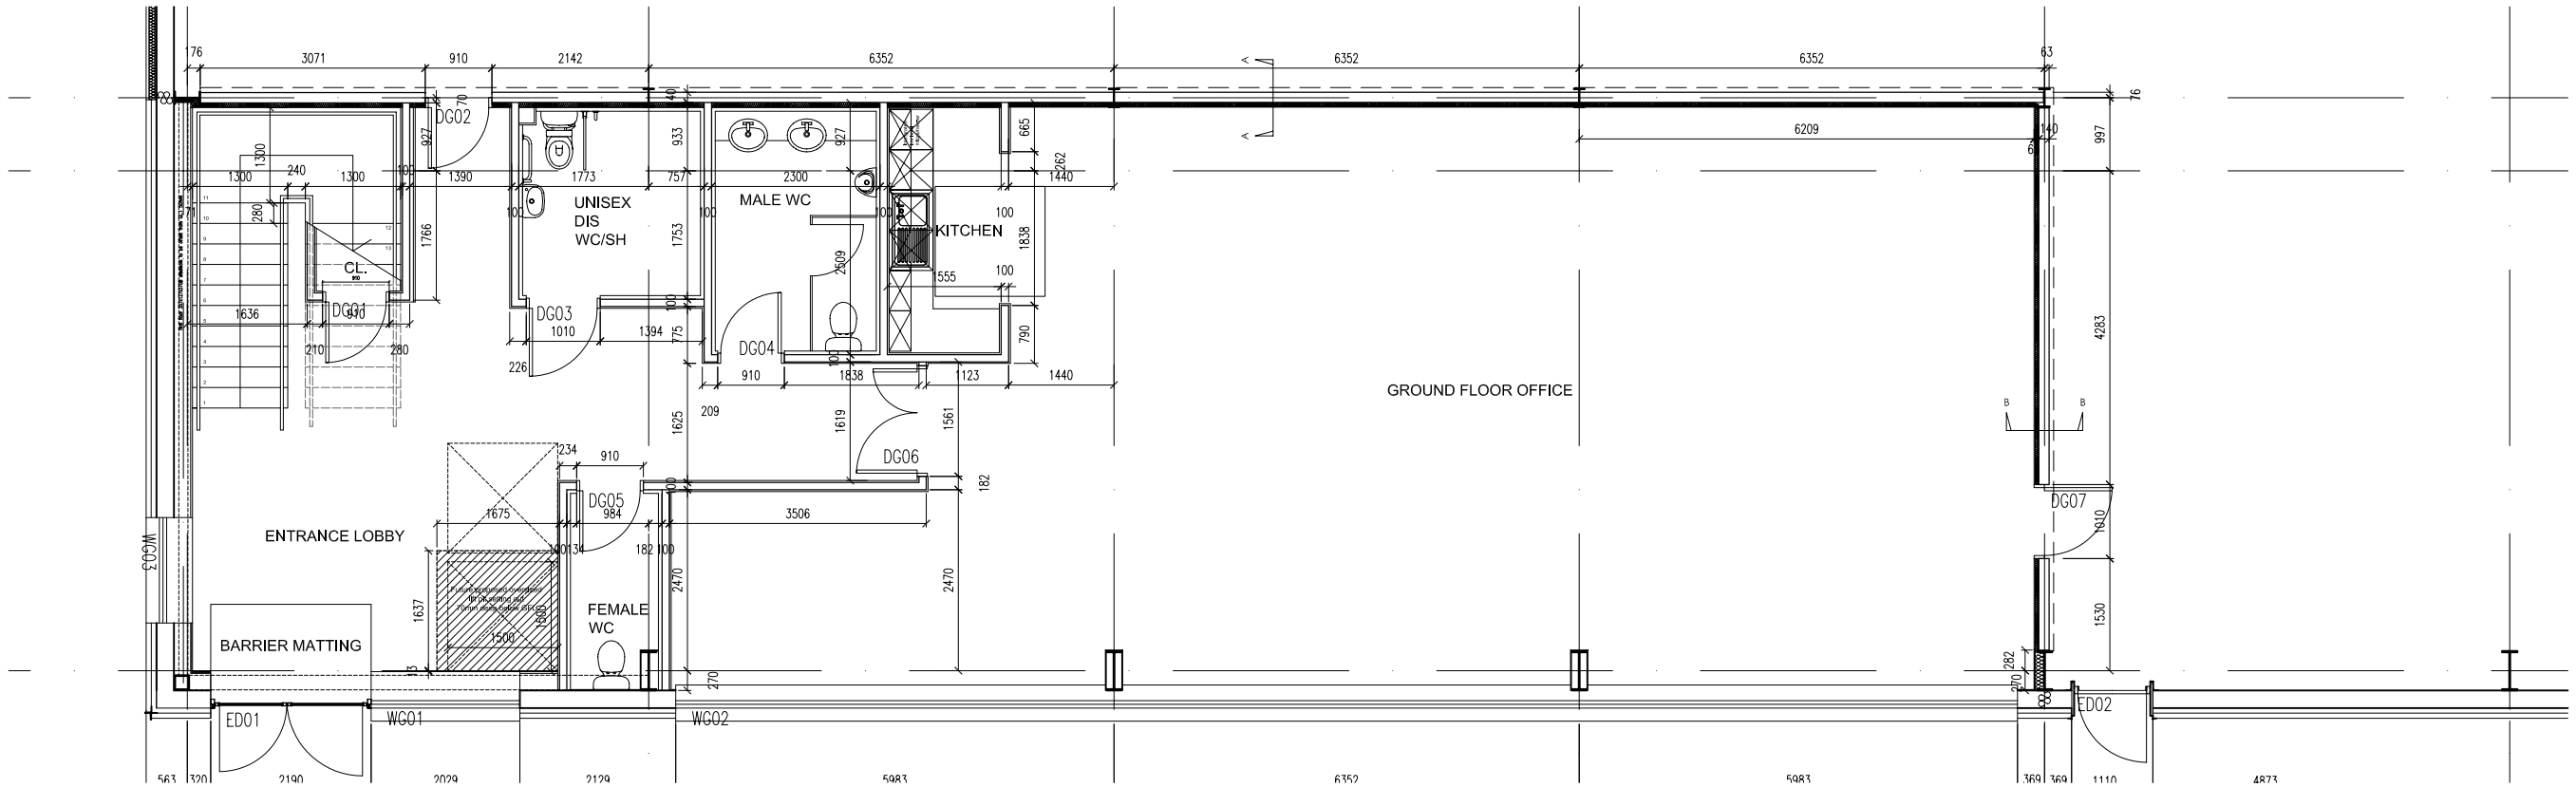

UNIT CD GROUND FLOOR
OFFICE CORE LAYOUT

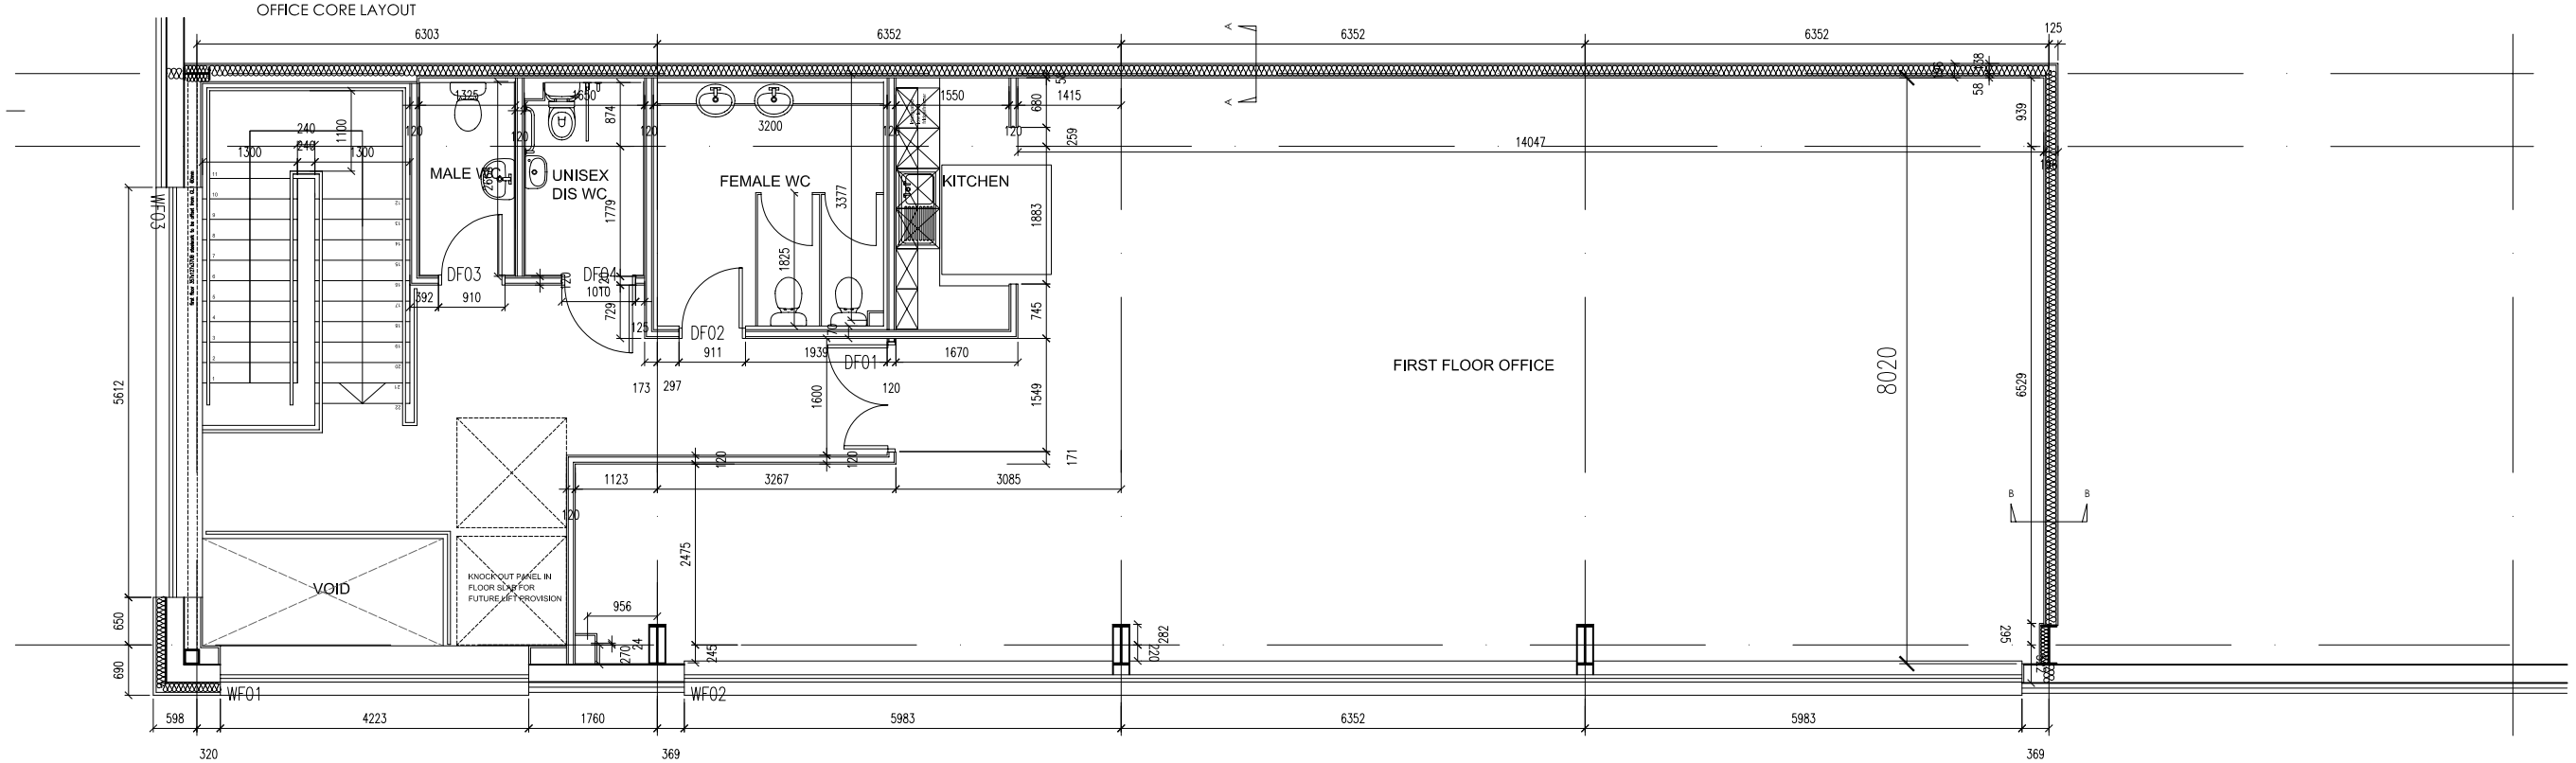

UNIT CD FIRST FLOOR
OFFICE CORE LAYOUT

SOUTHERN COMMERCIAL

UNIT C - OFFICE CORE LAYOUT 1:50

REV	DATE		DRAWN BY
A82	15.01.08	Amended to reflect as built info and Building Control comment, revision note sequence changed to A8	RCT
A B1	12.11.07	Shower to GF Dib WC removed	RCT

FletcherArchitects
Designers & Master Planners

UNITS 1 & 2 RIVERSIDE MEWS
COMMERCIAL STREET
MANCHESTER M15 4RQ

T +44(0)161 838 5360
F +44(0)161 838 5361

office@fletcherarchitects-uk.com
www.fletcherarchitects-uk.com

PROPOSED COMMERCIAL DEVELOPMENT
for HELIOS (INDUSTRIAL. DEVELOPMENTS) LTD
UNIT C - OFFICE CORE LAYOUT

STATUS	AB	P = PRELIMINARY C = CONSTRUCTION T = TENDER S = SKETCH	04.04.07
DRAWN :	RCT	CHECKED BY:	1:50@A1

1221 - AB123 AB2

UNIT C - OFFICE CORE LAYOUT
SOUTHERN COMMERCIAL

AS BUILT ISSUE

SCALE 1:50 @ A1