helioscity

Copyright Reserved to Fletcher Architects UK Ltd

These plans and specifications are the property of Fletcher Architects UK Ltd, and shall not be re-printed or reproduced, in whole or part, without their written consent, nor shall any building or structure be constructed in accordance with such plans and specifications or any modifications thereof without the written consent of Fletcher Architects UK Ltd.

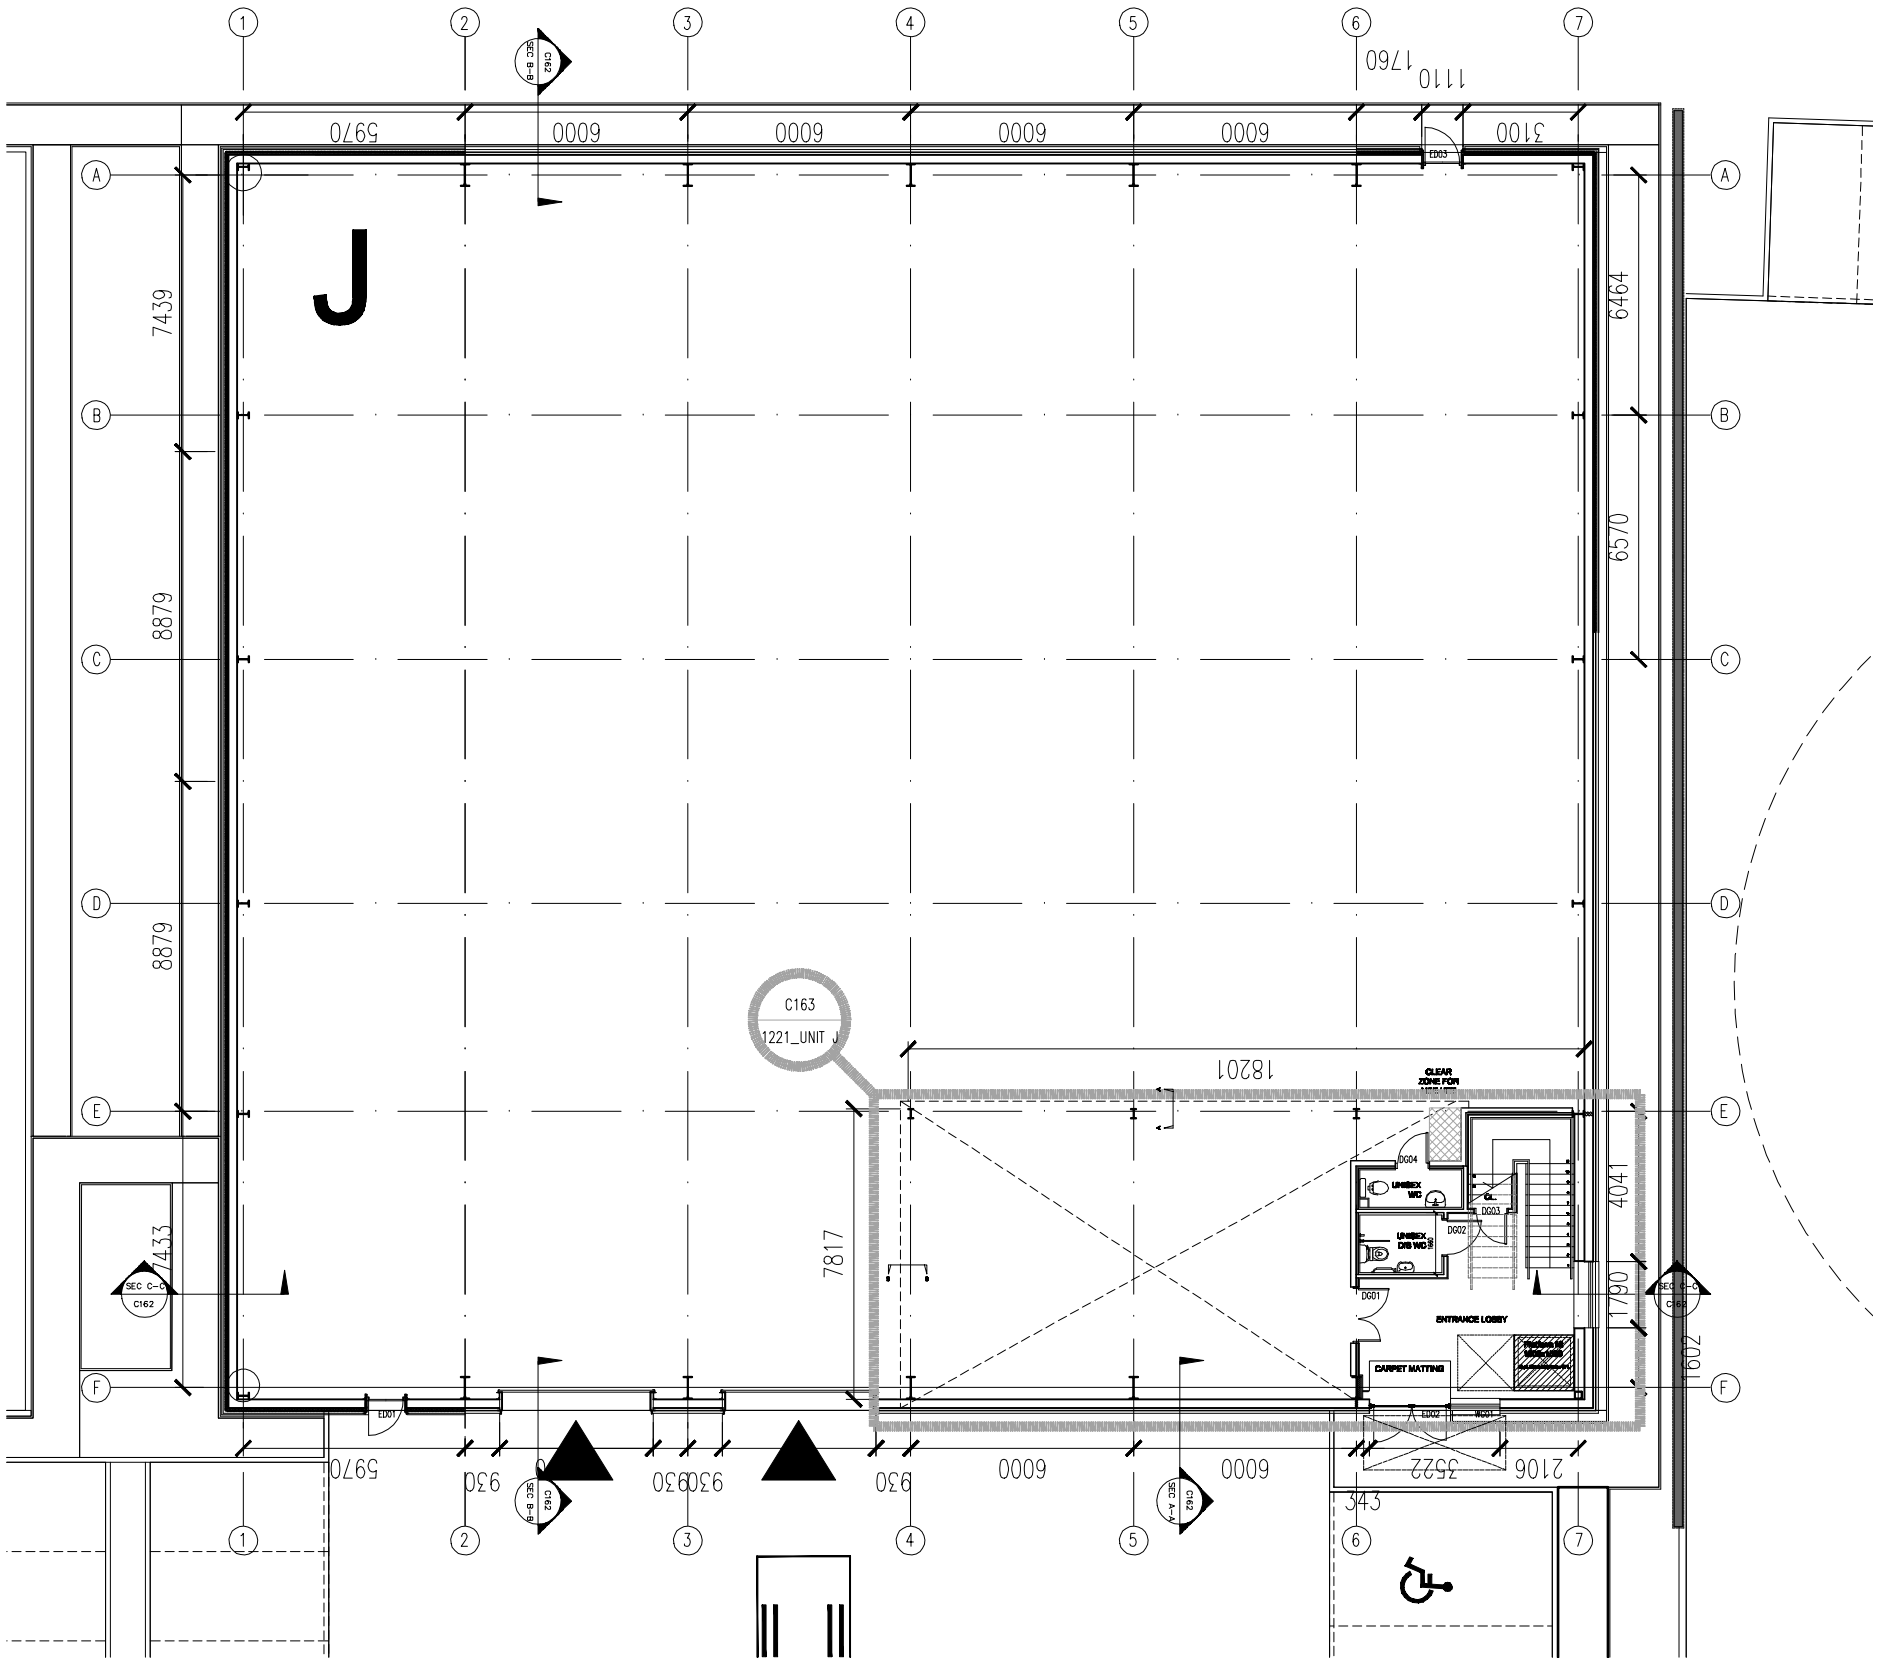


UNIT J - PROPOSED GA PLAN
SOUTHERN COMMERCIAL

AS BUILT ISSUE

SCALE 1:100 @ A1

SOUTHERN COMMERCIAL
UNIT J - PROPOSED GA PLAN 1:100

FletcherArchitects
Designers & Master Planners
UNITS 1 & 2 RIVERSIDE MEWS
COMMERCIAL STREET
MANCHESTER M15 4RQ
T +44(0)161 838 5360
F +44(0)161 838 5361
office@fletcherarchitects-uk.com
www.fletcherarchitects-uk.com

| REV | DATE | DRAWN BY |
|---|---|---|

PROPOSED COMMERCIAL DEVELOPMENT
for HELIOS (INDUSTRIAL DEVELOPMENTS) LTD
UNIT J - PROPOSED GA PLAN

| STATUS | AB | P = PRELIMINARY C = CONSTRUCTION | T = TENDER S = SKETCH | 30.05.07 |
|---|---|---|---|---|
| DRAWN : | RCT | CHECKED BY: | | 1:100@A1 |

1221 - AB160 | -